

# CERTIFICATE OF LOCATION OF GOVERNMENT CORNER

County of Anoka

State of Minnesota


Witness Corner of Sec. 28 Township 32 Range 25  
(On west line of SW1/4)

On the 9th day of September, 1975, the described corner was evidenced by area resurvey

and to perpetuate the location of said corner, at the exact location thereof, a permanent marker was placed consisting of a cast iron monument

AND on the 24th day of October, 2022, said permanent marker was found down 0.3'± and the ties were updated

Updated reference ties are as shown below.

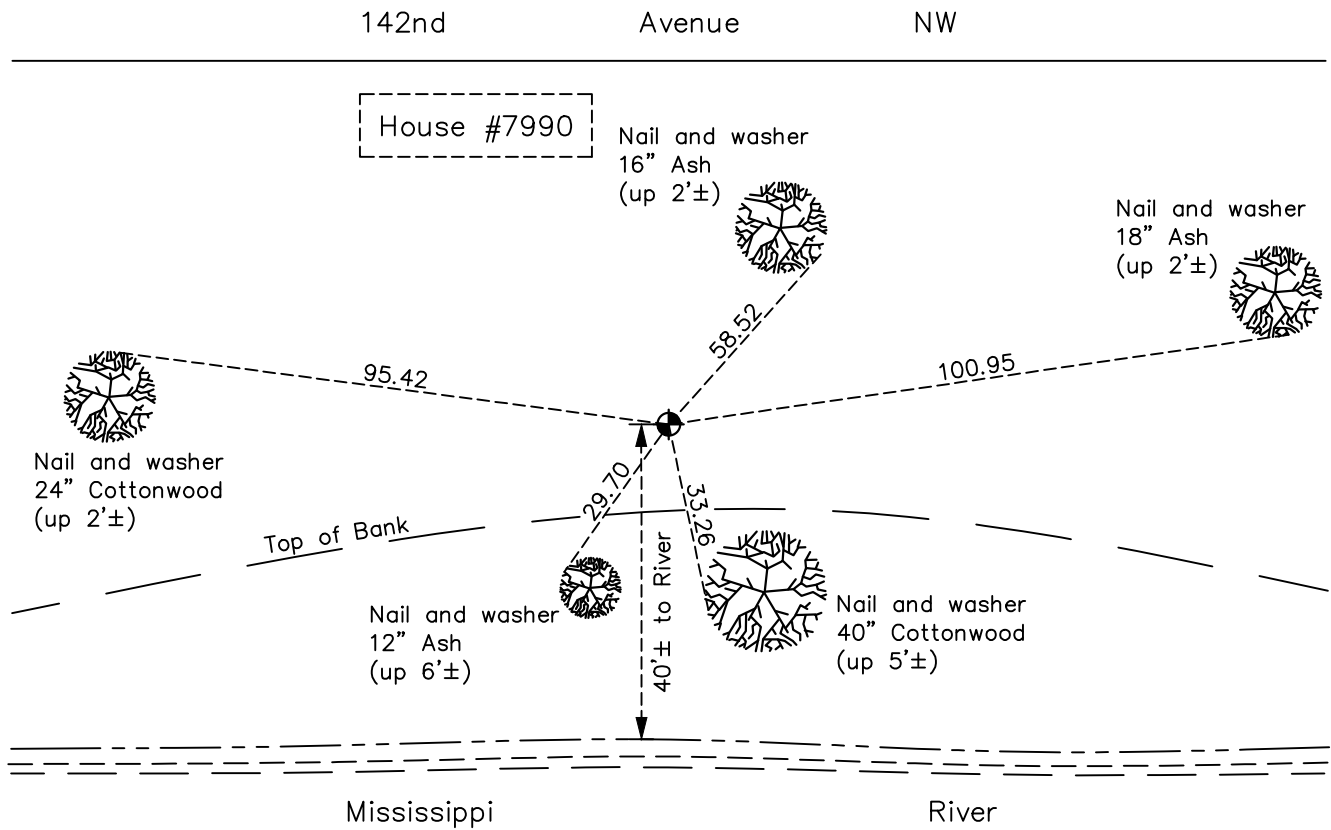

N  
  
 S

Revision Date  
 1/09/2023

N.A.D. 1983 Coordinates  
(1996 Adjustment)

County Project Coordinates	
Northing	170085.1261
Easting	447528.5393
Date	12/22/99

I hereby certify that this United States public land survey monument record is correct and complete to the best of my knowledge and belief.

*David Zieglmeier* Date 2/22/23

David Zieglmeier Anoka County Surveyor  
 Minnesota License Number 46179

# HISTORY OF GOVERNMENT CORNER

Page No. 121A

County of Anoka

State of Minnesota

Witness Corner of Sec. 28 Township 32 Range 25  
(On west line of SW1/4)

## **CORNER HISTORY:**

September 9, 1975 – Set cast iron monument flush with the surface using area resurvey and established ties to monument. Set sign and post on south side of monument.

July 8, 1976 – Found cast iron monument and updated ties.

June 22, 1979 – Found cast iron monument and updated ties.

August 1, 1985 – Found cast iron monument and updated ties.

June 27, 1988 – Replaced cast iron monument using two remaining ties and updated ties.

August 20, 1993 – Found cast iron monument and updated ties.

December 22, 1999 – Found cast iron monument and established NAD 1983 (1996 Adjustment) Anoka County Project Coordinates by Static GPS methods. Updated ties.

May 25, 2010 – Found cast iron monument and updated ties.

October 20, 2015 – Found cast iron monument down 0.5'± and updated ties.

May 20, 2020 – Found cast iron monument down 0.5'± and updated ties. Verified position of corner by VRS GPS method.

October 24, 2022 – Found cast iron monument down 0.3'±, verified the position by VRS GPS method and the ties were updated.