

CERTIFICATE OF LOCATION OF GOVERNMENT CORNER

County of Anoka

State of Minnesota


Witness Corner of Sec. 34 Township 32 Range 25

(On west line of section)

On the 12th day of October, 2022, the described corner was evidenced by a 4"X4" concrete monument. Found leaning south along eroding bank to river. Removed Feb 21st 2023. and to perpetuate the location of said corner a permanent marker was placed consisting of Set Cast iron monument 80.00' feet North of previous location along section line.

AND on the 28th day of February, 2023, said permanent marker was Set Cast iron monument down 0.1'±. Sign and post 1' south. Verified position by RTK GPS. New ties created.

Updated reference ties are as shown below.

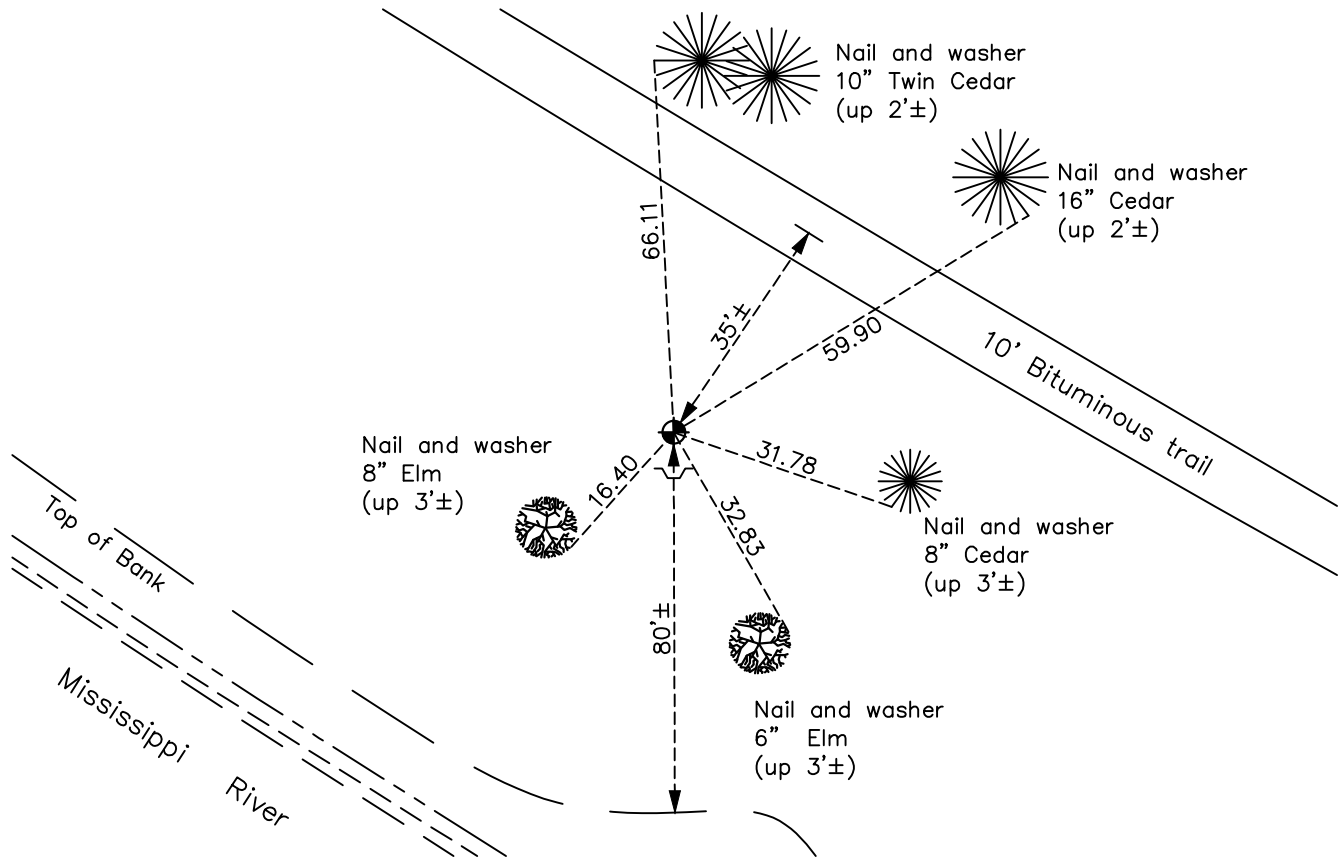

Revision Date
3/16/2023

N.A.D. 1983 Coordinates
 (2011 Adjustment)

County Project Coordinates	
Northing	<u>167358.6309</u>
Easting	<u>452832.7830</u>
Date	<u>2/28/2023</u>

I hereby certify that this United States public land survey monument record is correct and complete to the best of my knowledge and belief.
David Zieglmeier Date 4/14/23
 David Zieglmeier Anoka County Surveyor
 Minnesota License Number 46179

HISTORY OF GOVERNMENT CORNER

Page No. 124

County of Anoka

State of Minnesota

Witness Corner of Sec. 34 Township 32 Range 25
(On west line of section)

CORNER HISTORY:

May 10, 1944 - Cartwright found concrete monument and established ties to monument.

April 16, 1962 - Found 4" square concrete monument flush with the surface and updated ties. Set 1" iron pipe up 2'± and painted red on north side of monument.

August 12, 1964 - Found concrete monument and updated ties. Iron pipe is missing.

June 30, 1969 - Found concrete monument and updated ties. Set 1" iron pipe up 2'± and painted yellow on north side of monument.

8/22/1972, 7/8/1976, 7/5/1979, 8/17/1982, 7/29/1985 - Found concrete monument and updated ties.

June 28, 1988 - Found concrete monument with 1" iron pipe up 2'± on north side and updated ties.

8/20/1993, 4/25/1995 - Found concrete monument and updated ties.

January 11, 2001 - Found 4" X 4" concrete monument with a 1" iron pipe on north side of monument and a sign and post on the south side. Established NAD 1983 (1996 Adjustment) Anoka County Project Coordinates by Static GPS methods. Updated ties.

5/17/2010, 10/8/2015 - Found concrete monument flush with a sign and post on the south side. Updated ties.

March 18, 2020 - Found concrete monument flush with the surface with a sign and post on the south side and updated ties. Verified position of corner by VRS GPS

October 12, 2022 - Found concrete monument flush, verified the position of the corner by VRS GPS method and the ties were updated.

October 12, 2022 - Found 4"x4" concrete monument leaning south along eroding river bank. Removed concrete monument on 2/21/2023. Old position coordinates N: 167278.631 E: 452832.6778 (old index # 1454).

February 28, 2023 - Set cast iron monument 80' north along section line 0.1'± below the surface with sign and post 1' south. Verified position by RTK GPS. Established new ties to monument. (new index # 1594)