

~~XXXXXX~~

Ramsey

Page No. 133

CERTIFICATE OF LOCATION OF GOVERNMENT CORNER

County of Anoka

State of Minnesota

SOUTH SIXTEEN Corner of Sec. 36 Township 32 Range 25
OF S.E. QTR.

I hereby certify that on the 26 day of JUNE, 1969, I found the described corner which was evidenced by R.R. SPIKE

and I further certify that to perpetuate the location of said corner, I did, at the exact location thereof, place a permanent marker consisting of CLUSTER OF 4
MISC. IRONS TIES TAKEN TO R.R. SPIKE


which reference or witness monuments are located in the manner following:

I file 126 not distant given

1/18/23
JS

BEEPED ALL
AROUND + HEARD
NOTHING

* Position not
accurate enough to
Reset.

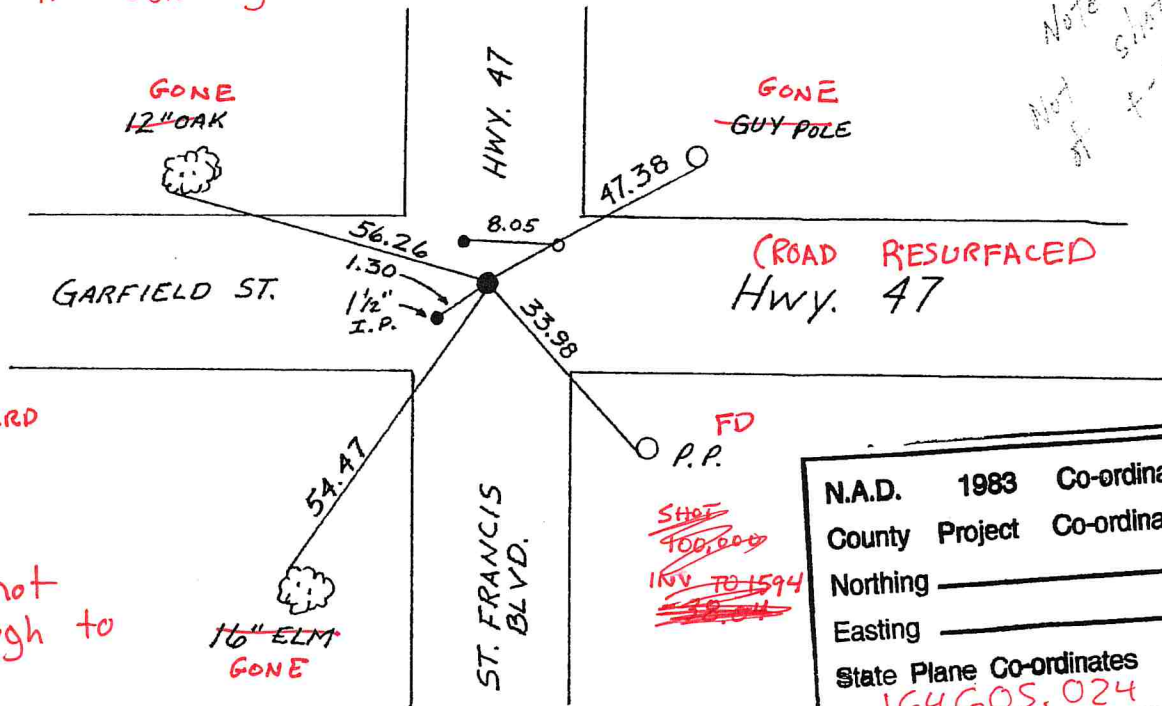

Note: Not shot 4-5-01

N.A.D.	1983	Co-ordinates
County	Project	Co-ordinates
Northing		
Easting		
State Plane Co-ordinates		
Y	164605.024	
X	467223.626	
Date		

NO MONUMENT

No Coord AVAILABLE
→ Calc only

Revised date	Revised date	Revised date
8-17-82		
7-17-85		
6-29-88		

