


Center corner of Section 31 T34 R24 P.36

Retired sandstone monument


7/17/97
H ASKEW
L GRAYSON
J SIMMER

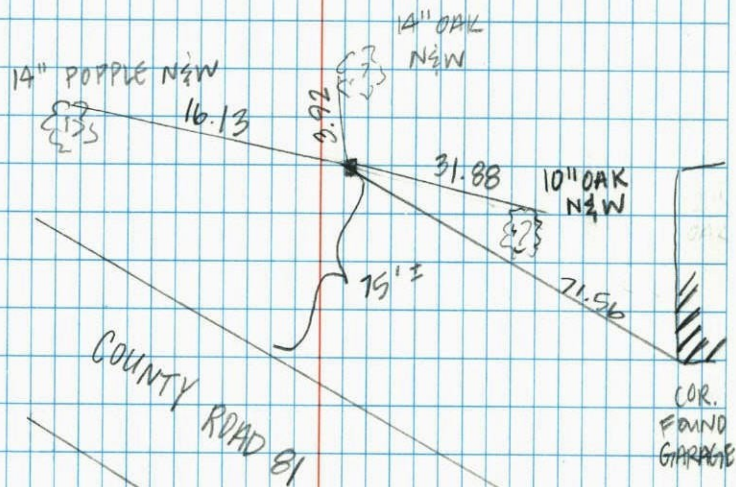

7-30-84 36
Center of Sec. 31 T34 R24

Found sandstone mount. used by
Donn Pepper. up 0.2' Center (Drill Hole)

Tie Check
June 30, 1970
D. Powell
R. Brien
W. Westlander

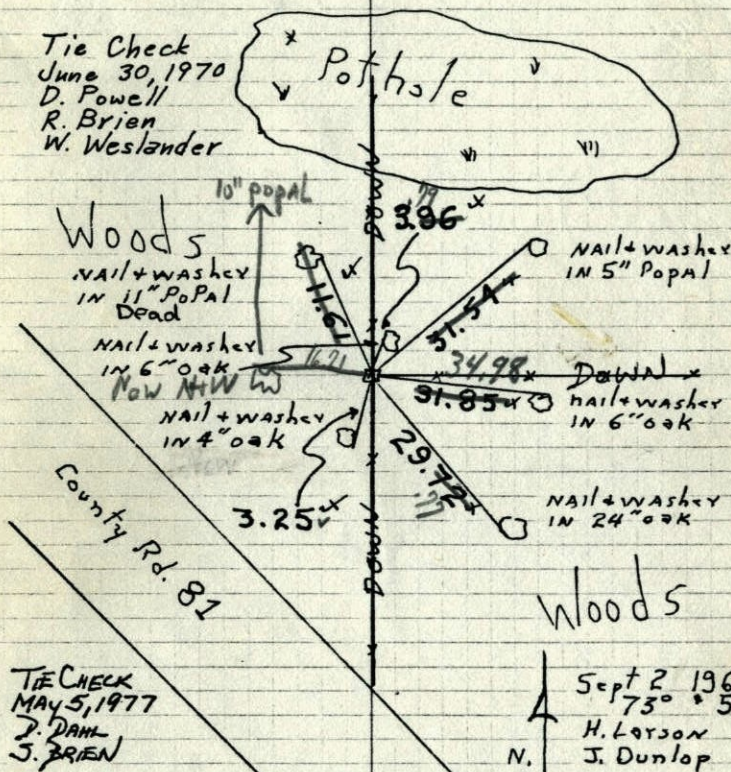

TIE CHECK
MAY 5, 1977
J. DAHL
J. BRIEN

Tie Check
G. Lips #200
D. Ross 72°
D. Vogel 72°
7-30-84

TIE CHECK
8-28-80
B. STEPHENS
P. ROSS
P. HORNSBY

Tie check
June 18, 1974
R. Farmer
N. Dahl
D. Dahl


Sept 2 1965
75° 5'
N.
H. Larson
J. Dunlop

TEMPERATURE CORRECTED
AND HORIZONTALLY
TAPED MEASUREMENTS

ROLAND W. ANDERSON
COUNTY SURVEYOR
ANOKA COUNTY, MINNESOTA

Center of Sec. 31 T34 R24

Found sandstone mount. used by
Donn Pepper. up 0.2±.

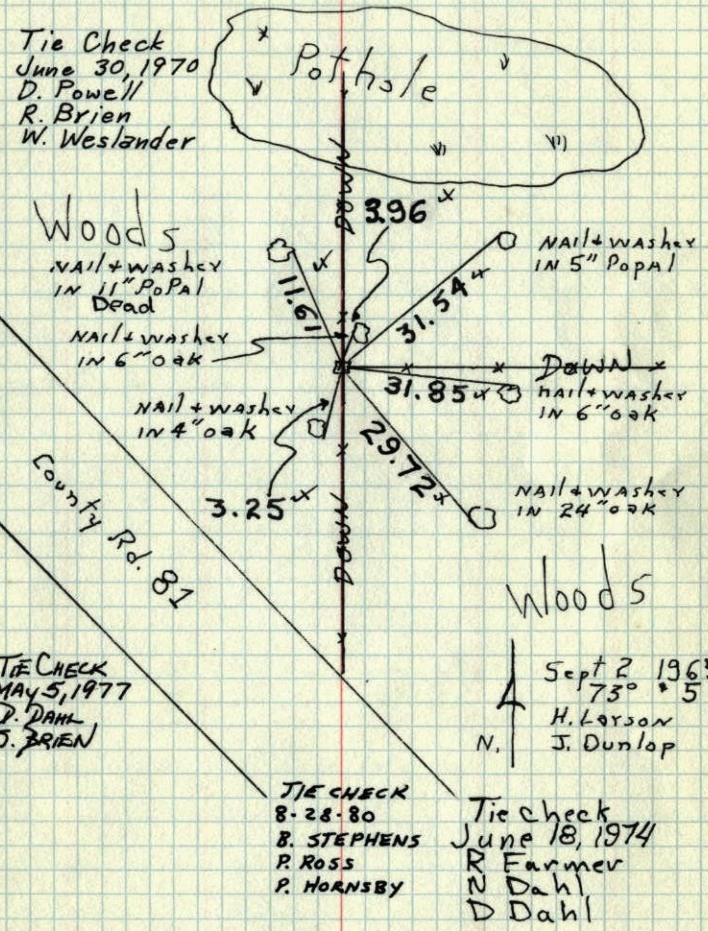


TEMPERATURE CORRECTED
AND HORIZONTALLY
TAPED MEASUREMENTS

ROLAND W. ANDERSON
COUNTY SURVEYOR
ANOKA COUNTY, MINNESOTA

X X

Center of Sec. 31 T34 R24

Found sandstone mount. used by
Donn Pepper. up 0.2±.

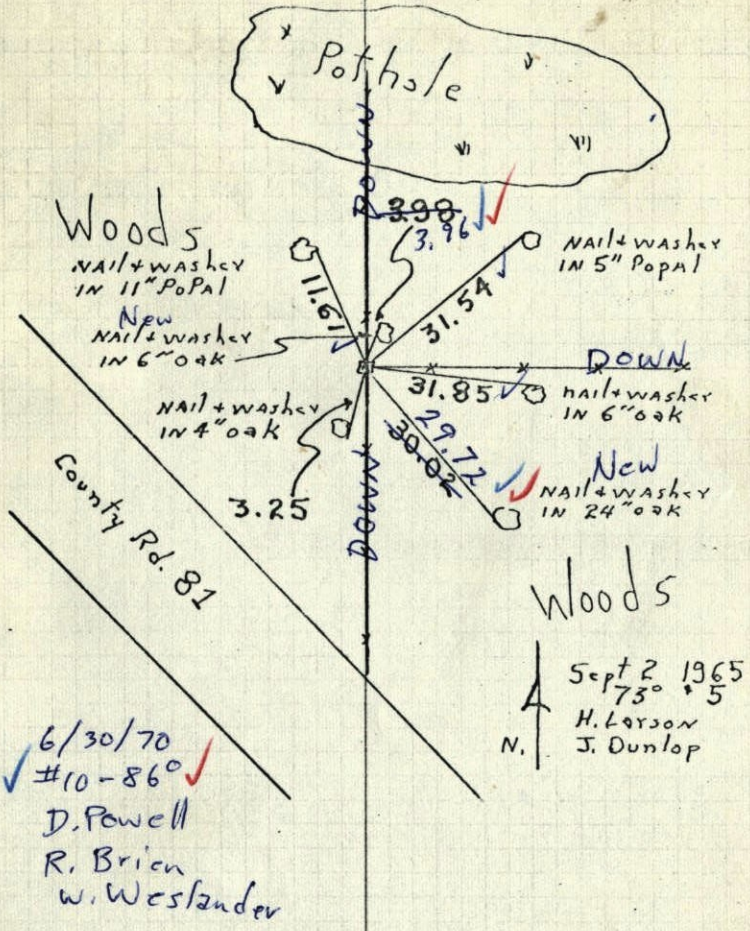


TEMPERATURE CORRECTED
AND HORIZONTALLY
TAPED MEASUREMENTS

ROLAND W. ANDERSON
COUNTY SURVEYOR
ANOKA COUNTY, MINNESOTA

Center of 31 T34 R24


Found sandstone Mt. used by Donn
Pepper. up .3'

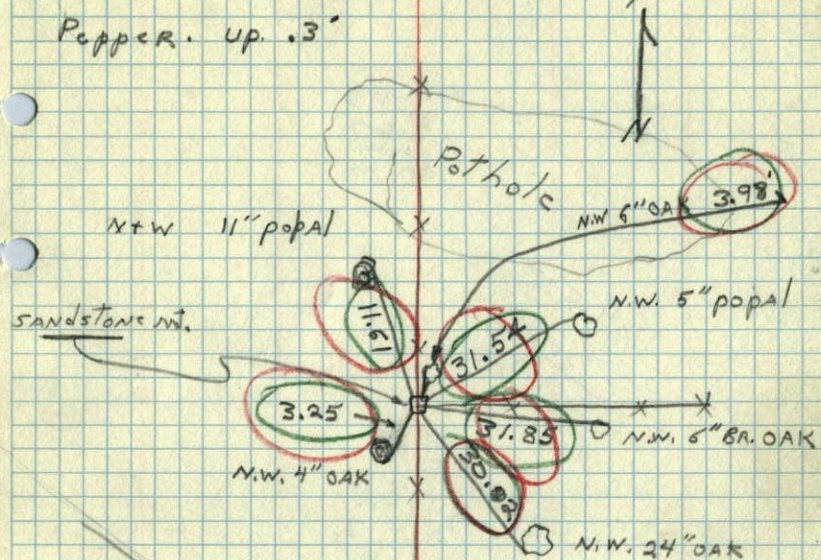

Center of Section ⁹

Sec. 31, T 34, R 24

Found Sandstone Mon at
Fence cor. 9-25-63 JD-MK

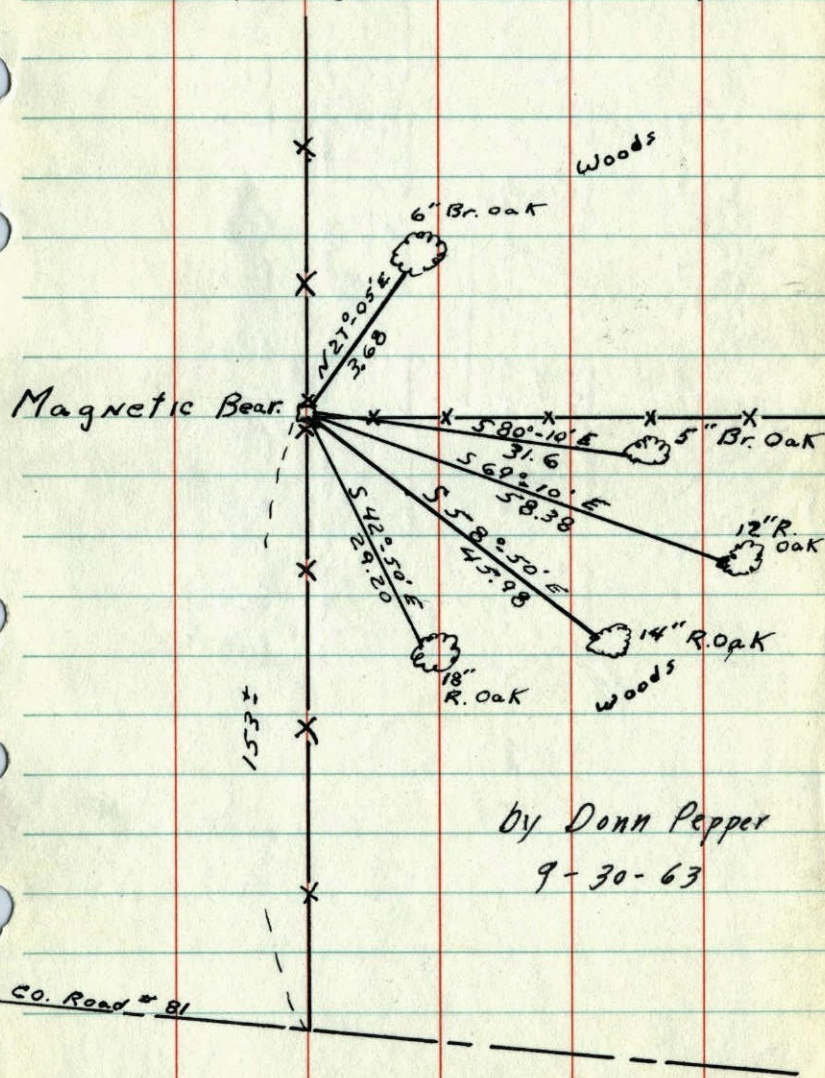

9
Center of Section
Sec. 31, T 34, R 24
Found Sandstone Mon at
Fence cor. 9-25-63 JD-MK

