


S $\frac{1}{4}$ Cor. Sec. 32-T34-R25

Set Cast Iron Monument from area resurvey.

Monument up 0.1'±.

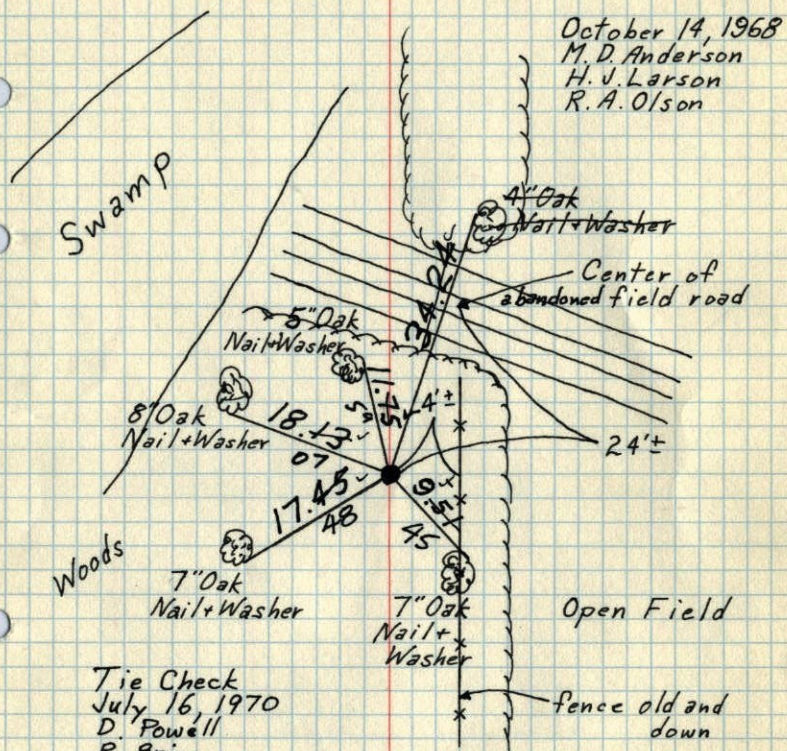

Tie Check
July 16, 1970
D. Powell
R. Brien

Tie Check
June 12, 1974
R. Farmer
N. Dahl
D. Dahl

TIE CHECK
MAY 12, 1977
R. SANNEBY
D. DAHL

Tie Check
5-27-81
P. Ross
P. Horby


TEMPERATURE CORRECTED
AND HORIZONTALLY
TAPED MEASUREMENTS

ROLAND W. ANDERSON
COUNTY SURVEYOR
ANOKA COUNTY, MINNESOTA

S $\frac{1}{4}$ Cor. Sec. 32-T34-R25

Set Cast Iron Monument from area resurvey.

Monument up 0.1'±.

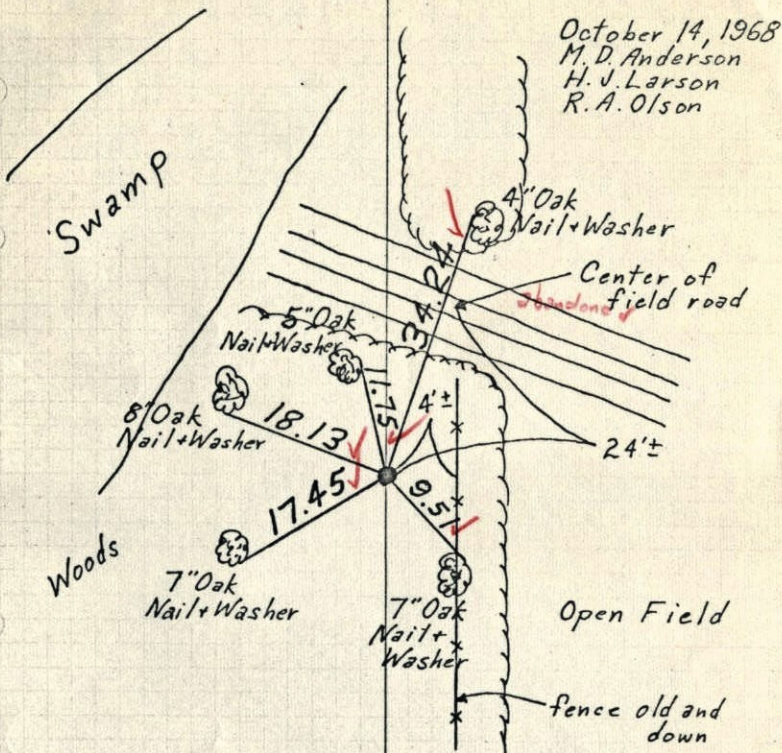


7/16/70
D. Powell
R. Brien

TEMPERATURE CORRECTED
AND HORIZONTALLY
TAPED MEASUREMENTS

ROLAND W. ANDERSON
COUNTY SURVEYOR
ANOKA COUNTY, MINNESOTA

5.1/4 Corn. Sec. 32-T34-R25
set C.I. Mon. from area resurvey
C.I. Mon. up 0.1'

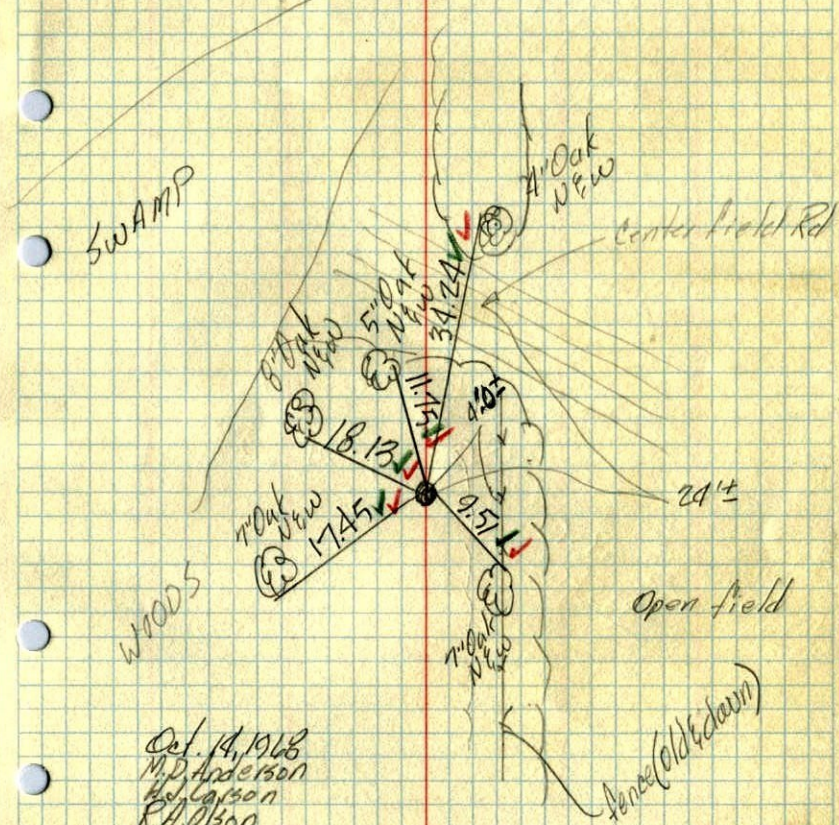

Oct. 14, 1968
M.P. Anderson
R. Larson
R.A. Olson

Temp. 70° ✓
Tape 45 ✓