


E 1/4 Cor. Sec. 25 - T 34 - R 24

Set Cast Iron Monument from
area resurvey

Set Steel sign post with warning sign
1' E N. of Monument

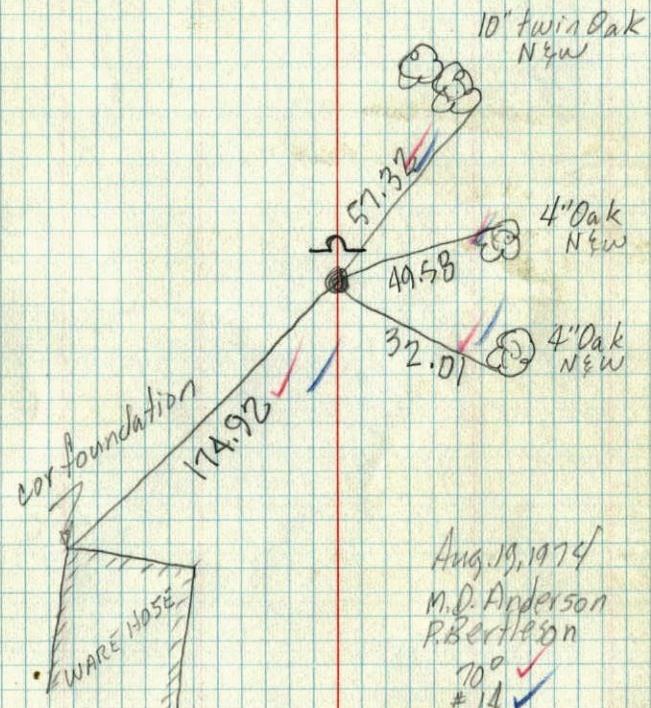

Aug 19, 1974
M.J. Anderson
P. Bertleson
70° ✓
#14 ✓