

CERTIFICATE OF LOCATION OF GOVERNMENT CORNER

County of Anoka

State of Minnesota

BLOCK


VILLAGE OF ST. FRANCIS

SOUTHWEST Corner of Sec. 9 Township Range


I hereby certify that on the 17th day of JULY, 19 64, I found the described corner which was evidenced by 10x10x30 CUT ROCK 1/2" DRILLED HOLE IN CENTER

and I further certify that to perpetuate the location of said corner, I did, at the exact location thereof, place a permanent marker consisting of 1/2" IRON PIPE IN CONCRETE SIDEWALK

which reference or witness monuments are located in the manner following:

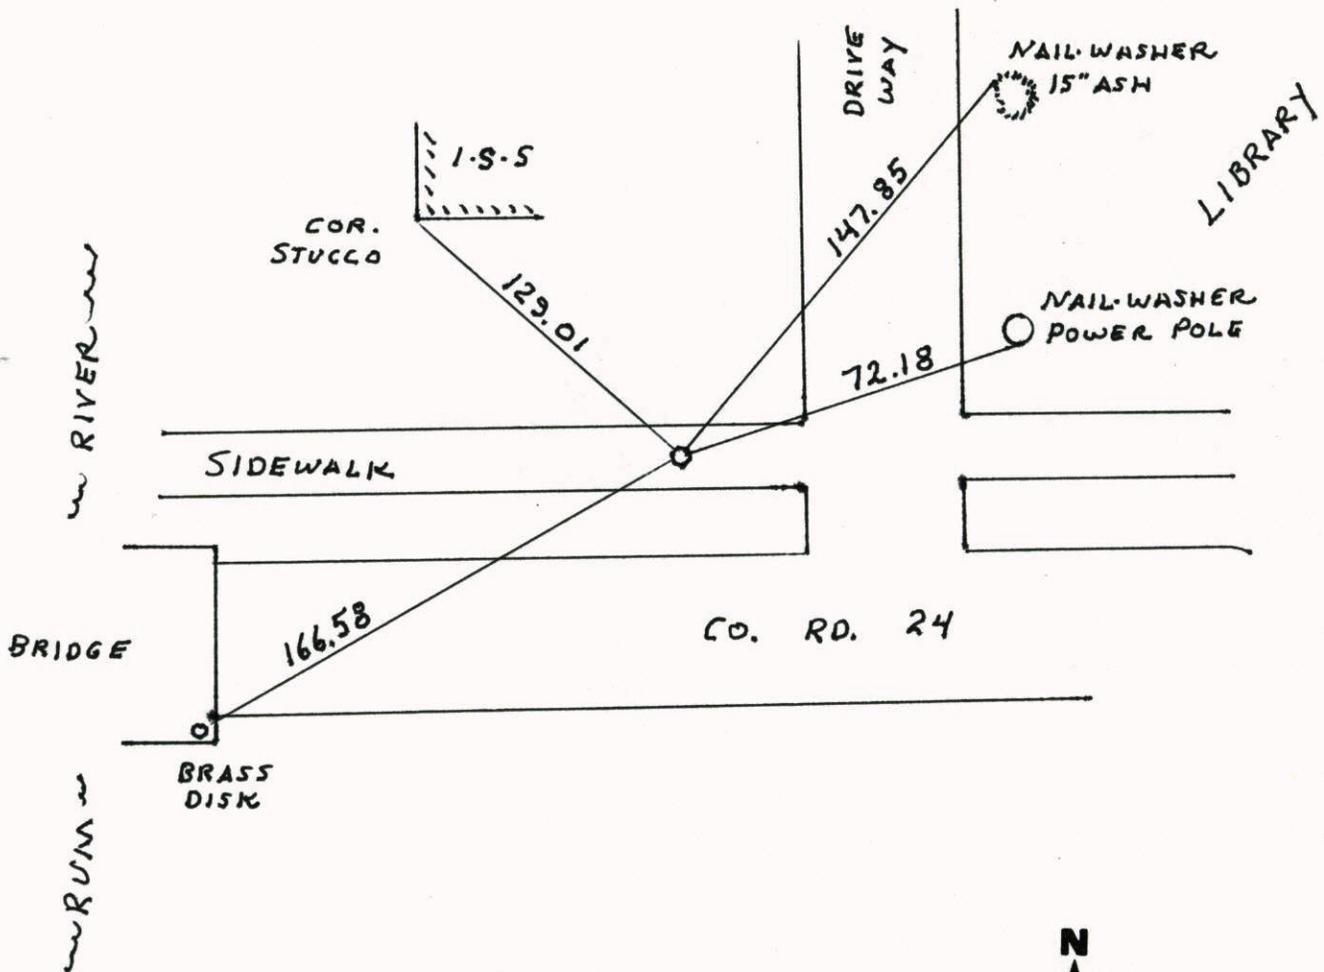


Revised date	Revised date	Revised date
7-28-97 HL		

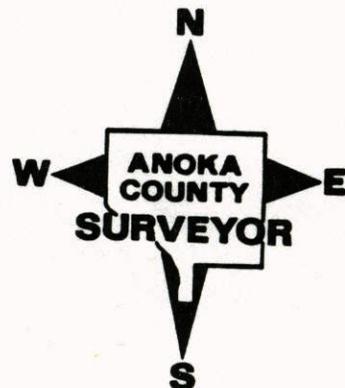

SW COR BLOCK 9 VILLAGE OF ST. FRANCIS

SET 1/2" IRON PIPE FROM TIES

1 P IN CONCRETE SIDEWALK

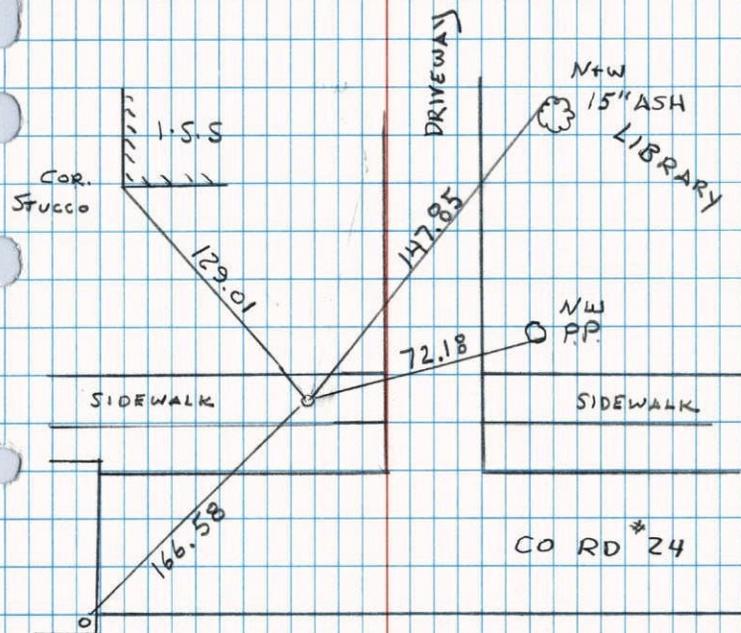


BRASS DISK
IN BRIDGE

7-28-97
WILSON
B. KLEMM
S. SIMMER

POINT IN CENTER OF OLD ROAD SO. OF
S.W. COR. BLOCK 9 VILLAGE OF ST.
FRANCIS

10" x 10" x 30" Sq. CUT ROCK WITH 1/2"
HOLE DRILLED IN TOP CENTER

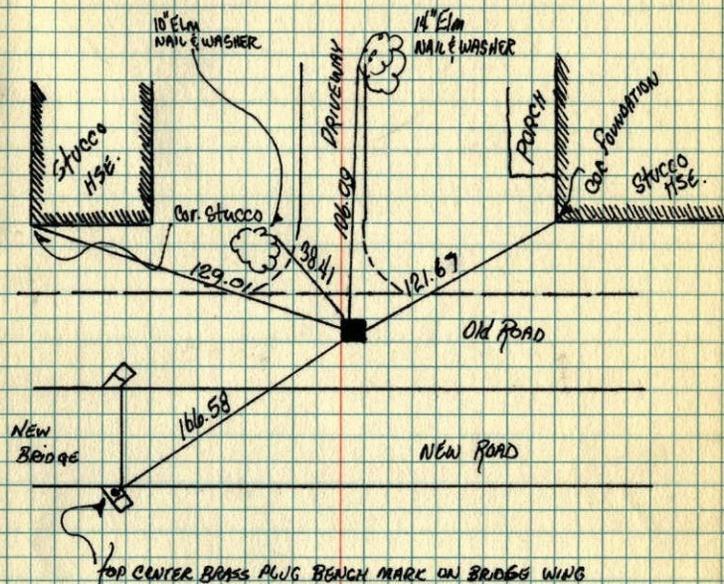

July 17, 1964


M.D. ANDERSON
R. CARLSON

ROLAND W. ANDERSON
COUNTY SURVEYOR
ANOKA COUNTY, MINNESOTA

TEMPERATURE CORRECTED
AND HORIZONTALLY
TAPED MEASUREMENTS

Point in center of old road So. of
Sw Cor. Block 9 VILLAGE OF ST. FRANCIS

10" x 10" x 30" Sq. cut rock with 1/2" hole drilled in top center

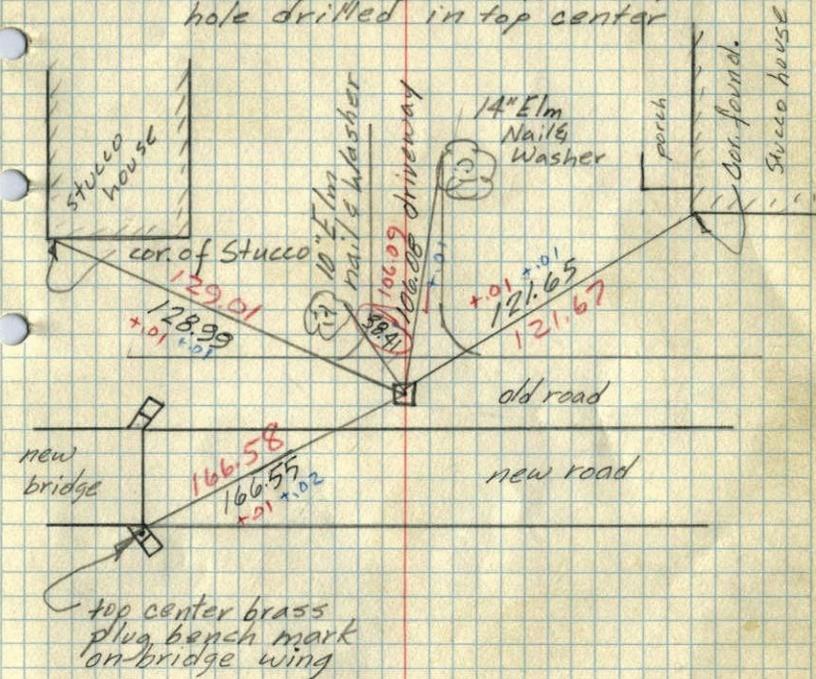

July 1st, 1964

M. D. Anderson
R. Carlson

Temp. 75°
Tape #1