

# CERTIFICATE OF LOCATION OF GOVERNMENT CORNER

County of Anoka

State of Minnesota


## North $\frac{1}{4}$ Corner of Sec. 28 Township 34 Range 24

On the 9th day of May, 1969, the described corner was evidenced by area resurvey

and to perpetuate the location of said corner, at the exact location thereof, a permanent marker was placed consisting of a cast iron monument

AND on the 9th day of November, 2022, said permanent marker was found down 0.5'± and the ties were updated

Updated reference ties are as shown below.

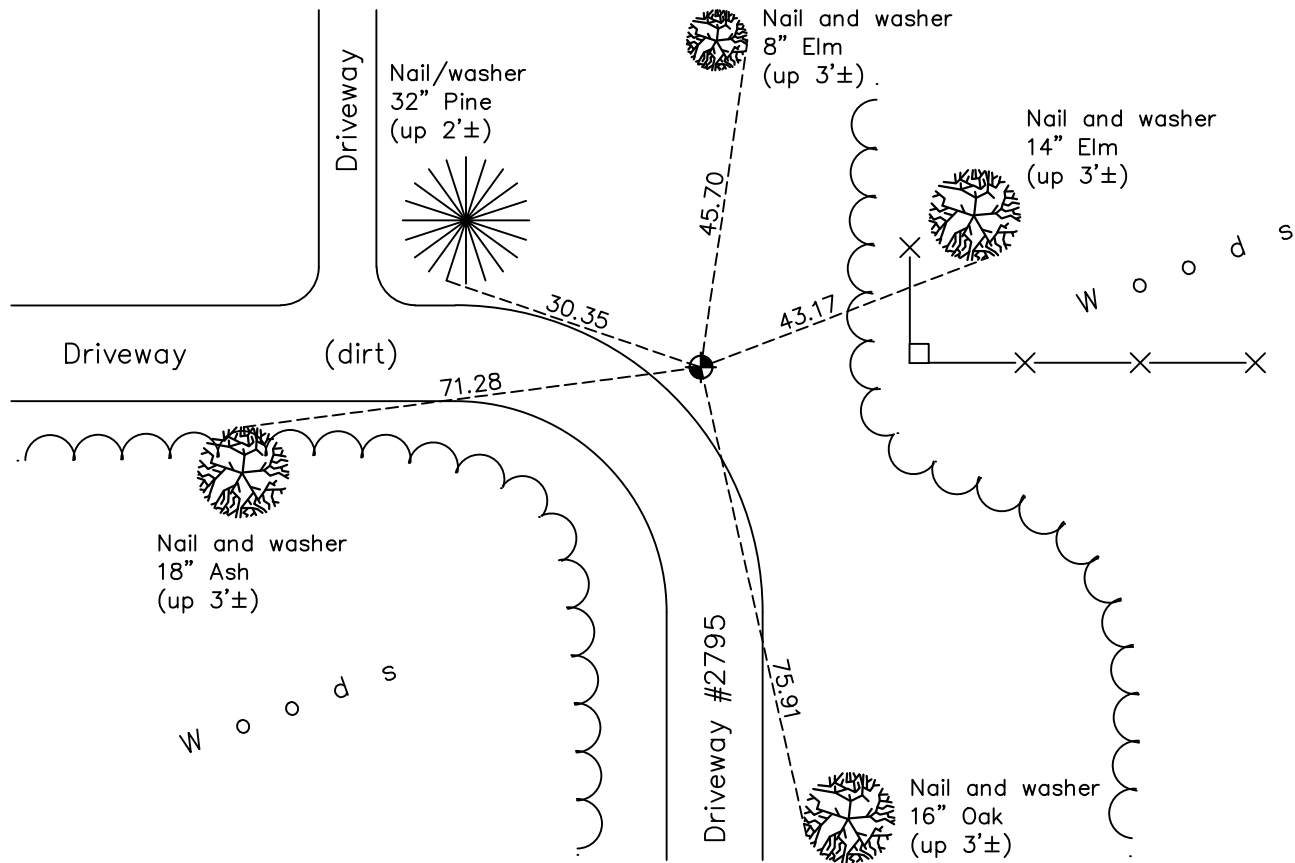

Revision Date  
1/25/2023

N.A.D. 1983 Coordinates  
(1996 Adjustment)

County Project Coordinates	
Northing	<u>237971.2766</u>
Easting	<u>481877.2736</u>
Date	<u>4/22/03</u>

I hereby certify that this United States public land survey monument record is correct and complete to the best of my knowledge and belief.

*David Zieglsmeier* Date 2/22/23

David M. Zieglsmeier, Anoka County Surveyor  
Minnesota License Number 46179

# HISTORY OF GOVERNMENT CORNER

Page No. 8

County of Anoka

State of Minnesota

## North 1/4 Corner of Sec. 28 Township 34 Range 24

### **CORNER HISTORY:**

May 9, 1969 - Set cast iron monument down 0.5'± using area resurvey. Established ties to monument.

June 10, 1974 - Found cast iron monument and updated ties.

May 3, 1977 - Found cast iron monument and updated ties.

August 26, 1980 - Found cast iron monument and updated ties.

July 25, 1984 - Found cast iron monument and updated ties.

June 15, 1987 - Found cast iron monument and updated ties.

July 23, 1992 - Found cast iron monument and updated ties.

July 17, 1997 - Found cast iron monument and updated ties.

April 22, 2003 - Established NAD 1983 (1996 adj.) Anoka County project coordinates by static GPS methods.

April 3, 2014 - Found cast iron monument down 0.5'± and updated ties.

July 1, 2020 - Found cast iron monument down 0.5'±. Verified position by VRS GPS methods. Updated ties.

November 9, 2022 - Found cast iron monument down 0.5'±, verified position by VRS GPS method and updated ties.