

# CERTIFICATE OF LOCATION OF GOVERNMENT CORNER

County of Anoka

State of Minnesota


## Northeast Corner of Sec. 33 Township 34 Range 24

On the 30th day of July, 2021, the described corner was evidenced by a 2" red and white iron pipe, up 6'±

and to perpetuate the location of said corner, at the exact location thereof, a permanent marker was placed consisting of a 8' steel Telspar with a cap and punchmark

AND on the 17th day of November, 2022, said permanent marker was found steel Telspar up 1'± with cap and punch mark and a sign/ post to the north. No ties available.

Updated reference ties are as shown below.

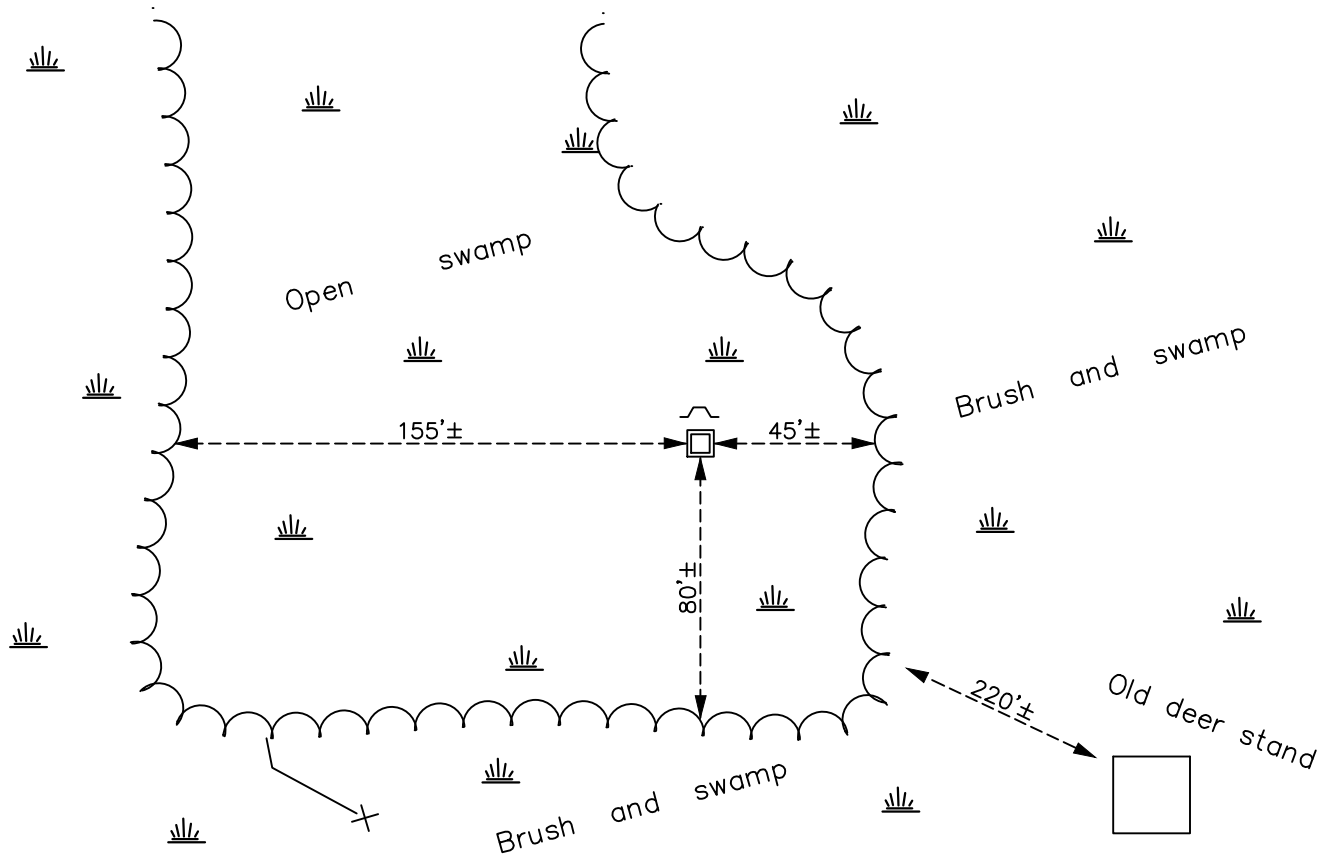

Revision Date  
 1/25/2023

N.A.D. 1983 Coordinates  
 (1996 Adjustment)

County Project Coordinates	
Northing	<u>232688.1331</u>
Easting	<u>484530.7255</u>
Date	<u>4/23/03</u>

I hereby certify that this United States public land survey monument record is correct and complete to the best of my knowledge and belief.  
David Zieglmeier Date 3/1/23  
 David Zieglmeier Anoka County Surveyor  
 Minnesota License Number 46179

# HISTORY OF GOVERNMENT CORNER

Page No. 28

County of Anoka

State of Minnesota

## Northeast Corner of Sec. 33 Township 34 Range 24

### **CORNER HISTORY:**

January 20, 1965 - Set 1" x 10' red and white iron pipe up 3.5'± using area resurvey. Corner ties unavailable.

July 20, 1970 - Found red and white iron pipe and established one corner tie.

May 5, 1977 - Found red and white iron pipe and updated ties.

June 5, 1981 - Found red and white iron pipe and updated ties.

October 14, 1991 - Found red and white iron pipe and updated ties.

April 23, 2003 - Found red and white iron pipe. Corner ties unavailable. Established NAD 1983 (1996 adj.) Anoka County project coordinates by static GPS methods.

April 15, 2014 - Found 2" red and white iron pipe up 5'±. Verified position by VRS GPS methods. No corner ties.

July 29, 2021 - Found red and white iron pipe up 6'±. Verified position by VRS GPS method. No ties available.

July 30, 2021 - Replaced red and white iron pipe with a 8' steel Telspar set up 1'± with a cap and punchmark. Set sign and post on the North side. Verified position of corner by VRS GPS method.

November 17, 2022 - Found steel Telspar up 1'± with cap and punch mark and verified position by VRS GPS method. No ties available.