

# CERTIFICATE OF LOCATION OF GOVERNMENT CORNER

County of Anoka

State of Minnesota

CENTER Corner of Sec. 32 Township 34 Range 24

I hereby certify that on the 30 day of October, 19 74, I found the described corner which was evidenced by AREA RESURVEY

and I further certify that to perpetuate the location of said corner, I did, at the exact location thereof, place a permanent marker consisting of CAST IRON MONUMENT DOWN 2'±  
SIGN & POST NORTH SIDE

which reference or witness monuments are located in the manner following:

1-27-2021


SS  
GONE  
NEWER SUBDIVISION  
WITH HOMES IN  
THE MIDDLE 2000'

UNDERCLIFT ST NW

R #23255

ROAD

FIELD

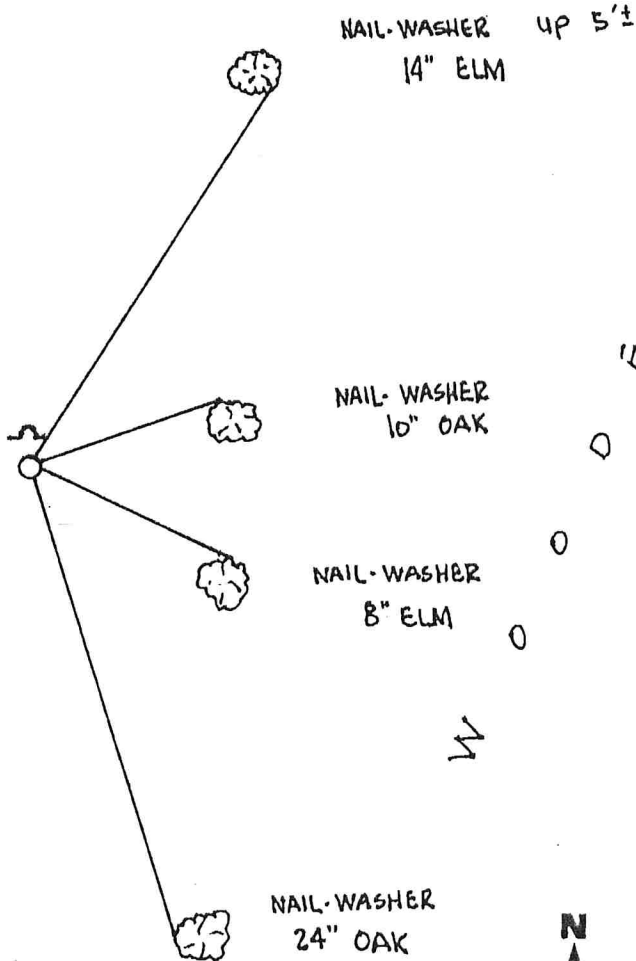

Revised date	Revised date	Revised date
5-5-77		
8-22-80		
7-30-84		
6-16-87		
7-24-92		
7-28-97		

