

CERTIFICATE OF LOCATION OF GOVERNMENT CORNER

County of Anoka

State of Minnesota


North 1/4 Corner of Sec. 25 Township 34 Range 25

On the 4th day of May, 1983, the described corner was evidenced by a 3/4" iron pipe

and to perpetuate the location of said corner, at the exact location thereof, a permanent marker was placed consisting of a cast iron monument

AND on the 4th day of November, 2022, said permanent marker was found flush with a sign and post on the south side and the ties were updated

Updated reference ties are as shown below.

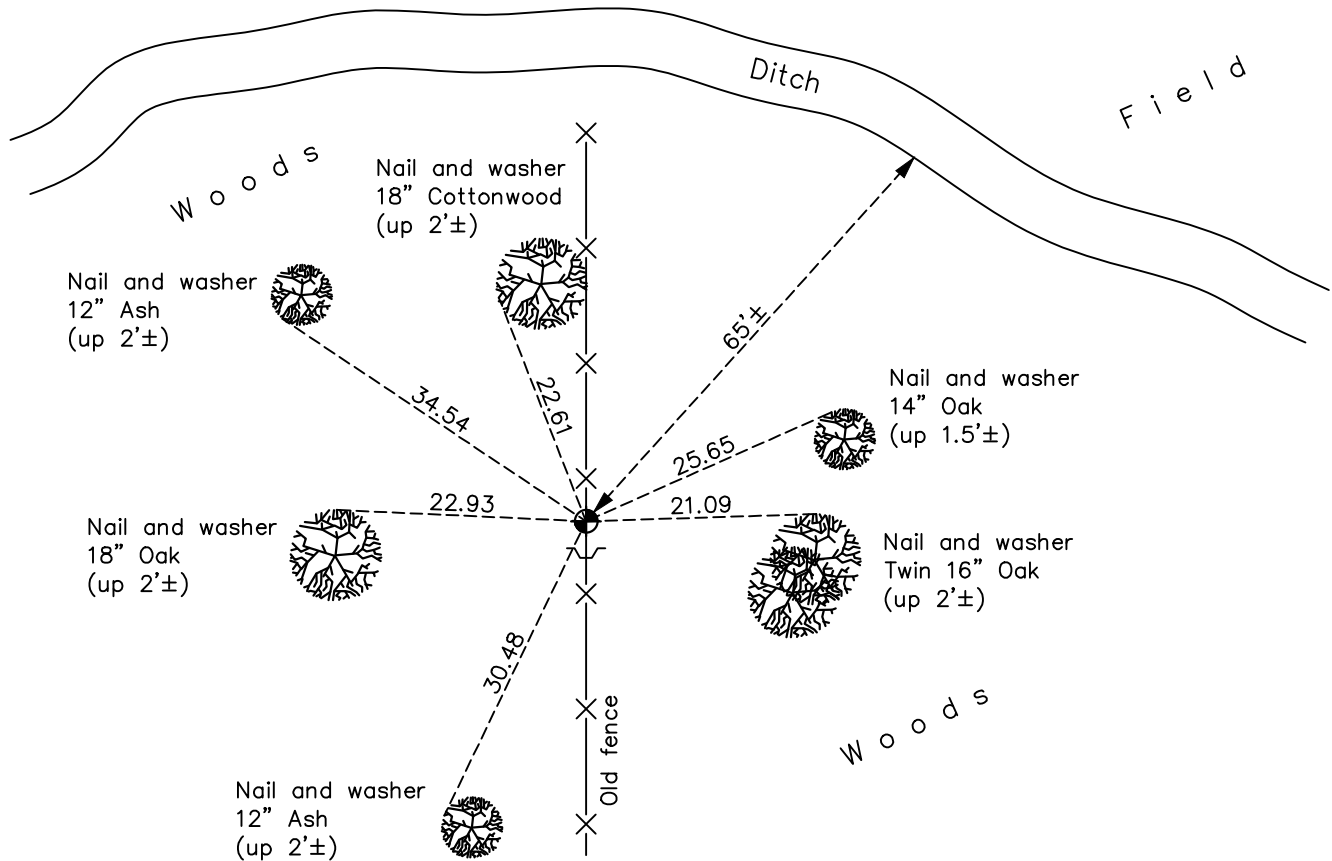

Revision Date
1/31/2023

N.A.D. 1983 Coordinates
 (1996 Adjustment)

County Project Coordinates	
Northing	<u>238019.4440</u>
Easting	<u>466099.9372</u>
Date	<u>5/01/03</u>

I hereby certify that this United States public land survey monument record is correct and complete to the best of my knowledge and belief.
David Zieglmeier Date 3/1/23
 David Zieglmeier Anoka County Surveyor
 Minnesota License Number 46179

HISTORY OF GOVERNMENT CORNER

Page No. 45

County of Anoka

State of Minnesota

North 1/4 Corner of Sec. 25 Township 34 Range 25

CORNER HISTORY:

February 11, 1974 - Set a 3/4" iron pipe w/sign and post on the north side. Established ties to iron pipe.

August 26, 1980 - Found iron pipe and updated ties.

May 4, 1983 - Replaced iron pipe with a cast iron monument. Updated ties. Set sign and post on south side.

June 24, 1987 - Found cast iron monument and updated ties.

July 20, 1992 - Found cast iron monument and updated ties.

July 25, 1997 - Found cast iron monument and updated ties.

May 1, 2003 - Established NAD 1983 (1996 adj.) Anoka County project coordinates by static GPS methods.

April 1, 2014 - Found cast iron monument and updated ties.

September 10, 2020 - Found cast iron monument and updated ties.

November 4, 2022 - Found cast iron monument flush, verified position by VRS GPS method and updated ties.