

CERTIFICATE OF LOCATION OF GOVERNMENT CORNER

County of Anoka

State of Minnesota



West 1/4 Corner of Sec. 30 Township 34 Range 25

On the 14th day of January, 1964, the described corner was evidenced by a 3/4" iron pipe

and to perpetuate the location of said corner, at the exact location thereof, a permanent marker was placed consisting of a cast iron monument found September 2, 1969 w/ registration #5333

AND on the 7th day of November, 2022, said permanent marker was found down 0.5' with a sign and post on the north side, Ties were updated

Updated reference ties are as shown below.

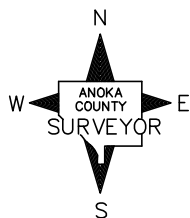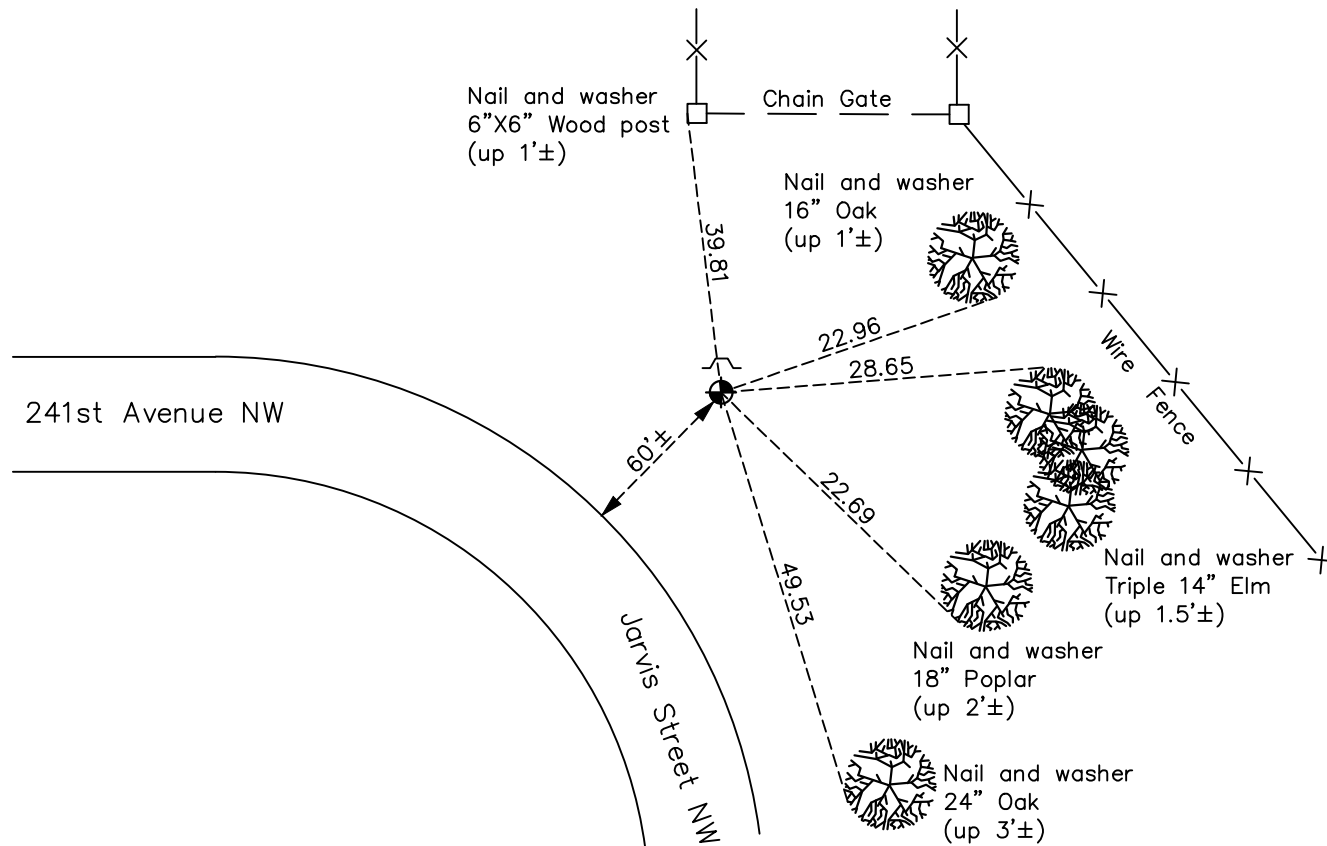

Revision Date
 2/01/2023

N.A.D. 1983 Coordinates
 (1996 Adjustment)

| County Project Coordinates | |
|----------------------------|--------------------|
| Northing | <u>235766.0531</u> |
| Easting | <u>437490.3514</u> |
| Date | <u>5/12/03</u> |

I hereby certify that this United States public land survey monument record is correct and complete to the best of my knowledge and belief.
David Zieglmeier Date 3/1/23
 David Zieglmeier Anoka County Surveyor
 Minnesota License Number 46179

HISTORY OF GOVERNMENT CORNER

Page No. 59

County of Anoka

State of Minnesota

West 1/4 Corner of Sec. 30 Township 34 Range 25

CORNER HISTORY:

January 14, 1964 - Found 3/4" pinched iron pipe up 0.1'± and updated ties.

September 1, 1965 - Found 3/4" pinched iron pipe and updated ties.

September 2, 1969 - Found cast iron monument w/registration #5333 up 0.2'± and updated ties.

June 10, 1974 - Found cast iron monument and updated ties.

May 9, 1977 - Found cast iron monument and updated ties.

May 28, 1981 - Found cast iron monument and updated ties.

July 27, 1984 - Found cast iron monument and updated ties.

June 18, 1987 - Found cast iron monument and updated ties.

December 14, 1993 - Found cast iron monument and updated ties.

July 17, 1997 - Found cast iron monument w/sign and post on the north side and updated ties.

May 12, 2003 - Established NAD 1983 (1996 adj.) Anoka County project coordinates by static GPS methods.

April 9, 2014 - Found cast iron monument and updated ties.

August 24, 2020 - Found cast iron monument down 0.5'±. Verified position by VRS GPS methods. Updated ties.

November 7, 2022 - Found cast iron monument down 0.5'±, verified position by VRS GPS method, updated ties