

CERTIFICATE OF LOCATION OF GOVERNMENT CORNER

County of Anoka

State of Minnesota


West 1/4 Corner of Sec. 26 Township 34 Range 25

On the 10th day of August, 1976, the described corner was evidenced by area resurvey

and to perpetuate the location of said corner, at the exact location thereof, a permanent marker was placed consisting of a solid cast iron monument with a sign and post on the northeast side

AND on the 14th day of November, 2022, said permanent marker was found up 0.1'± with a sign and post on the northeast side and the ties were updated

Updated reference ties are as shown below.

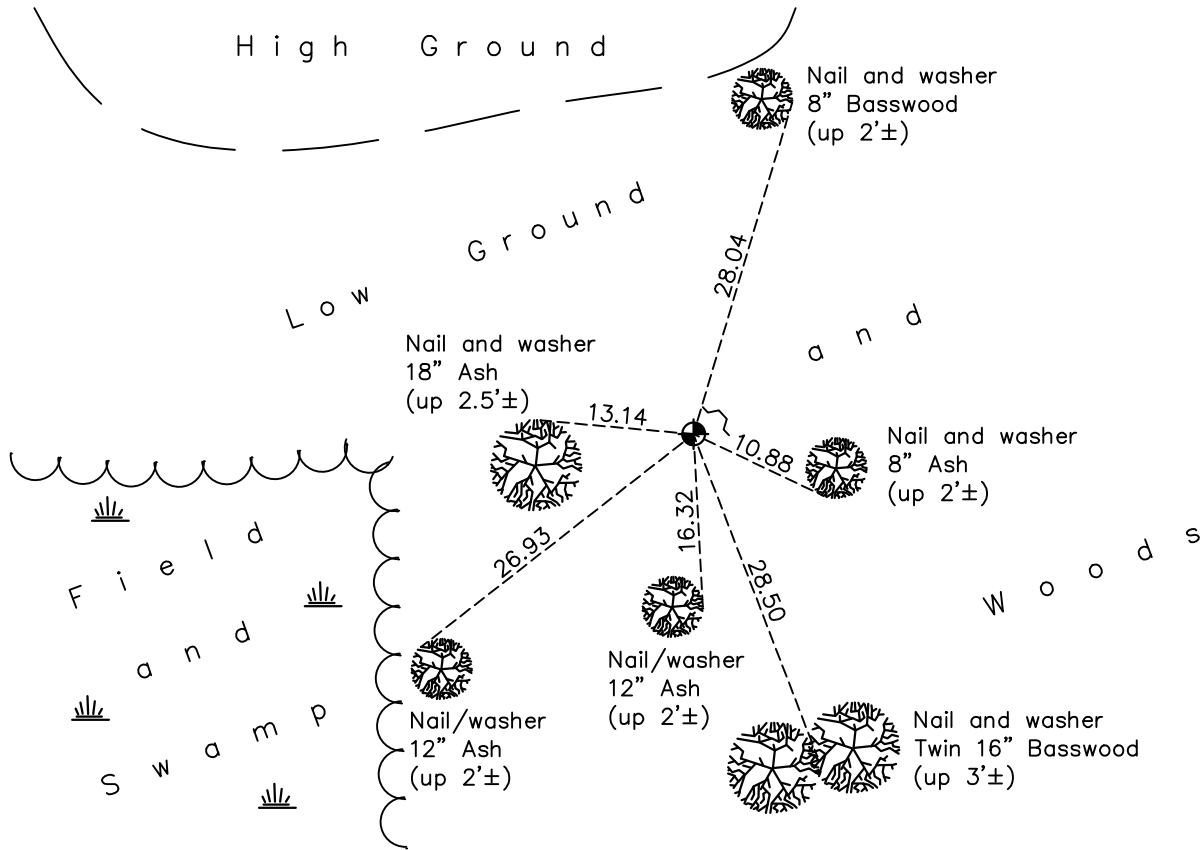

Revision Date

2/01/2023

N.A.D. 1983 Coordinates
(1996 Adjustment)

County Project Coordinates	
Northing	<u>235401.3522</u>
Easting	<u>458165.9967</u>
Date	<u>4/30/03</u>

I hereby certify that this United States public land survey monument record is correct and complete to the best of my knowledge and belief.

David Zieglmeier Date 3/1/23

David Zieglmeier Anoka County Surveyor
Minnesota License Number 46179

HISTORY OF GOVERNMENT CORNER

Page No. 63

County of Anoka

State of Minnesota

West 1/4 Corner of Sec. 26 Township 34 Range 25

CORNER HISTORY:

August 10, 1976 - Set cast iron monument flush using area resurvey. Established ties to monument.

May 9, 1977 - Found cast iron monument and updated ties.

July 31, 1984 - Found cast iron monument and updated ties.

June 24, 1987 - Found cast iron monument and updated ties.

April 30, 2003 - Found cast iron monument and updated ties. Established NAD 1983 (1996 adj.) Anoka County project coordinates by static GPS methods.

April 11, 2014 - Found cast iron monument with top broken off. Checked position to center fin using corner ties.

September 19, 2014 - Replaced broken cast iron monument with a new cast iron monument. Verified position by static GPS methods. Updated ties.

September 15, 2020 - Found cast iron monument and updated ties.

November 14, 2022 - Found cast iron monument up $0.1' \pm$, verified position by VRS GPS method and updated the ties.