

# CERTIFICATE OF LOCATION OF GOVERNMENT CORNER

County of Anoka

State of Minnesota


## South 1/4 Corner of Sec. 27 Township 34 Range 25

On the 11th day of August, 1976, the described corner was evidenced by area resurvey

and to perpetuate the location of said corner, at the exact location thereof, a permanent marker was placed consisting of a cast iron monument

AND on the 14th day of November, 2022, said permanent marker was found down 1'± with a sign and post on the south side. Ties were updated

Updated reference ties are as shown below.

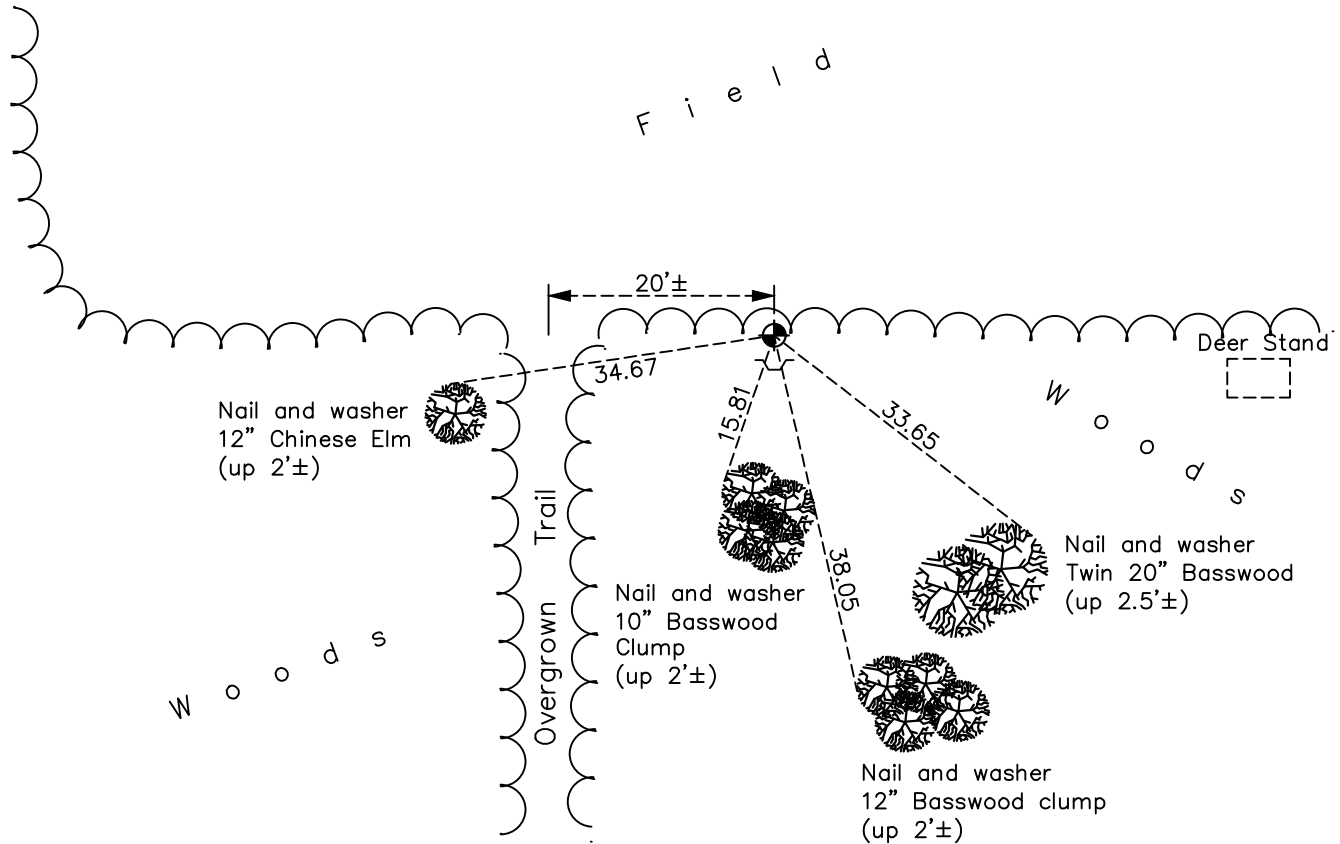

Revision Date  
 2/01/2023

N.A.D. 1983 Coordinates  
 (1996 Adjustment)

County Project Coordinates	
Northing	232812.8350
Easting	455512.0180
Date	5/13/03

I hereby certify that this United States public land survey monument record is correct and complete to the best of my knowledge and belief.  
*David Zieglmeier* Date 3/1/23  
 David Zieglmeier Anoka County Surveyor  
 Minnesota License Number 46179

# HISTORY OF GOVERNMENT CORNER

Page No. 70

County of Anoka

State of Minnesota

South 1/4 Corner of Sec. 27 Township 34 Range 25

## **CORNER HISTORY:**

August 11, 1976 - Set cast iron monument down 1'± using area resurvey. Established ties to monument.

May 10, 1977 - Found cast iron monument and updated ties.

June 2, 1981 - Found cast iron monument and updated ties.

July 31, 1984 - Found cast iron monument and updated ties.

June 24, 1987 - Found cast iron monument and updated ties.

July 27, 1992 - Found cast iron monument and updated ties.

July 23, 1997 - Found cast iron monument and updated ties.

May 9, 2003 - Found cast iron monument and updated ties.

May 13, 2003 - Established NAD 1983 (1996 adj.) Anoka County project coordinates by static GPS methods.

April 14, 2014 - Found cast iron monument down 1'±. Verified position by VRS GPS methods. Updated ties. Set sign and post on south side of monument on 7/31/14.

September 21, 2020 - Found cast iron monument down 1'± and updated ties.

November 14, 2022 - Found cast iron monument down 1'±, verified position by VRS GPS method, updated ties.