

CERTIFICATE OF LOCATION OF GOVERNMENT CORNER

County of Anoka

State of Minnesota


West 1/4 Corner of Sec. 31 Township 34 Range 25

On the 15th day of January, 1964, the described corner was evidenced by a 1 1/2" iron pipe

and to perpetuate the location of said corner, at the exact location thereof, a permanent marker was placed consisting of a cast iron monument found July 17, 1970 with registration #5333

AND on the 7th day of November, 2022, said permanent marker was found up 0.2'± with a fence post on the South side and the ties were updated

Updated reference ties are as shown below.

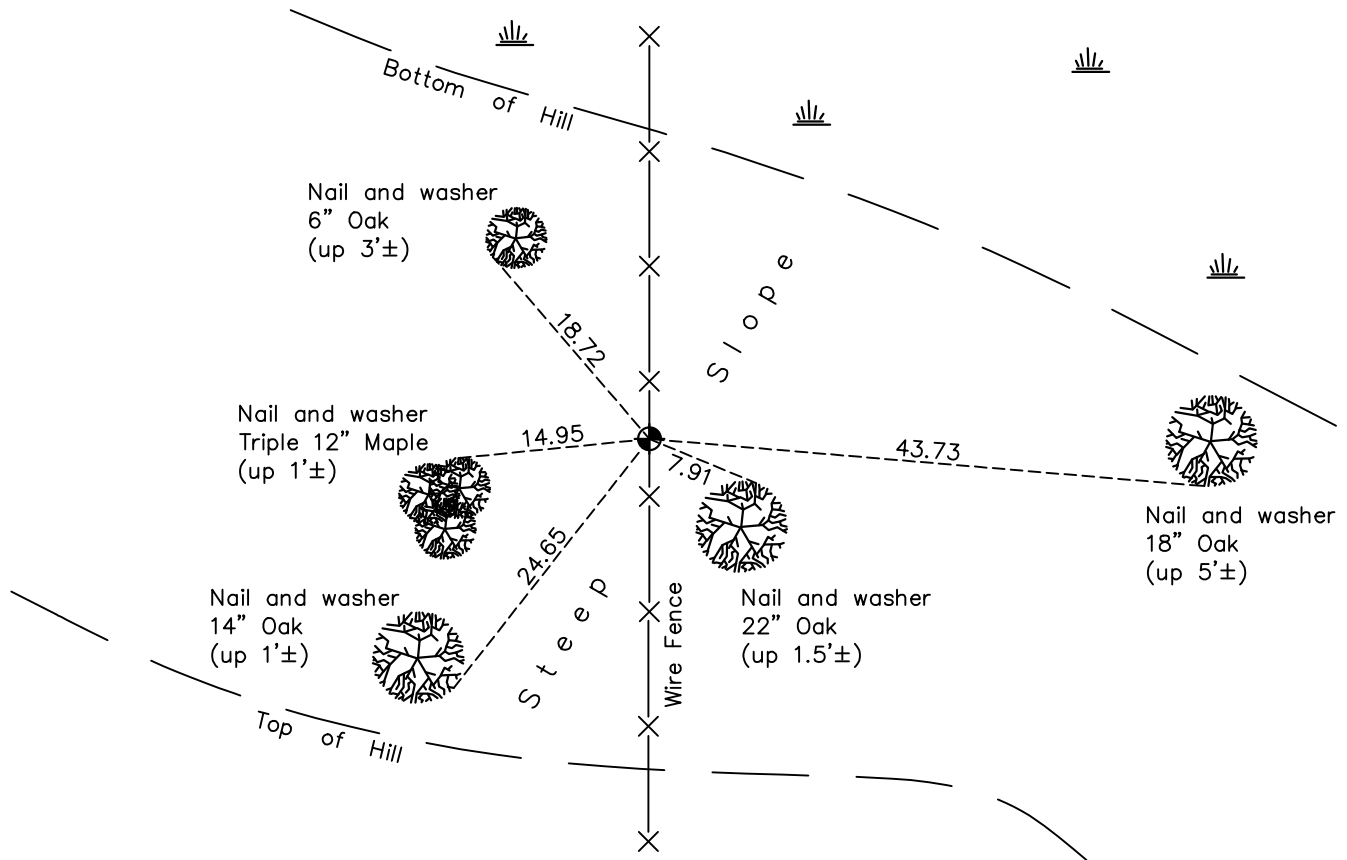

Revision Date

2/01/2023

N.A.D. 1983 Coordinates
(1996 Adjustment)

County Project Coordinates	
Northing	<u>230424.8517</u>
Easting	<u>437507.4653</u>
Date	<u>1/24/05</u>

I hereby certify that this United States public land survey monument record is correct and complete to the best of my knowledge and belief.

David Zieglmeier Date 3/1/23

David Zieglmeier Anoka County Surveyor
Minnesota License Number 46179

HISTORY OF GOVERNMENT CORNER

Page No. 78

County of Anoka

State of Minnesota

West 1/4 Corner of Sec. 31 Township 34 Range 25

CORNER HISTORY:

January 15, 1964 - Found 1-1/2" iron pipe up 0.5'± using Harvey Cartwright's ties. Iron pipe is leaning 0.1'± east and 0.1'± north. Updated ties.

September 3, 1965 - Found 1-1/2" iron pipe and updated ties.

July 17, 1970 - Found cast iron monument with registration #5333 up 0.3'± set where the 1-1/2" iron pipe was found using old Cartwright ties. Updated ties to cast iron monument.

June 10, 1974 - Found cast iron monument and updated ties.

May 10, 1977 - Found cast iron monument and updated ties.

June 5, 1981 - Found cast iron monument and updated ties.

July 27, 1984 - Found cast iron monument and updated ties.

June 18, 1987 - Found cast iron monument and updated ties.

January 24, 2005 - Established NAD 1983 (1996 adj.) Anoka County project coordinates by static GPS methods.

April 9, 2014 - Found cast iron monument up 0.2'± and updated ties.

August 24, 2020 - Found cast iron monument up 0.2'± w/fence post on the south side. Updated ties.

November 7, 2022 - Found cast iron monument up 0.2'±, verified position by VRS GPS method, updated ties.