

# CERTIFICATE OF LOCATION OF GOVERNMENT CORNER

County of Anoka

State of Minnesota


## West 1/4 Corner of Sec. 35 Township 34 Range 25

On the 13th day of October, 1970, the described corner was evidenced by area resurvey

and to perpetuate the location of said corner, at the exact location thereof, a permanent marker was placed consisting of a cast iron monument

AND on the 16th day of November, 2022, said permanent marker was found flush with a 'T' post on the north side and the ties were updated

Updated reference ties are as shown below.

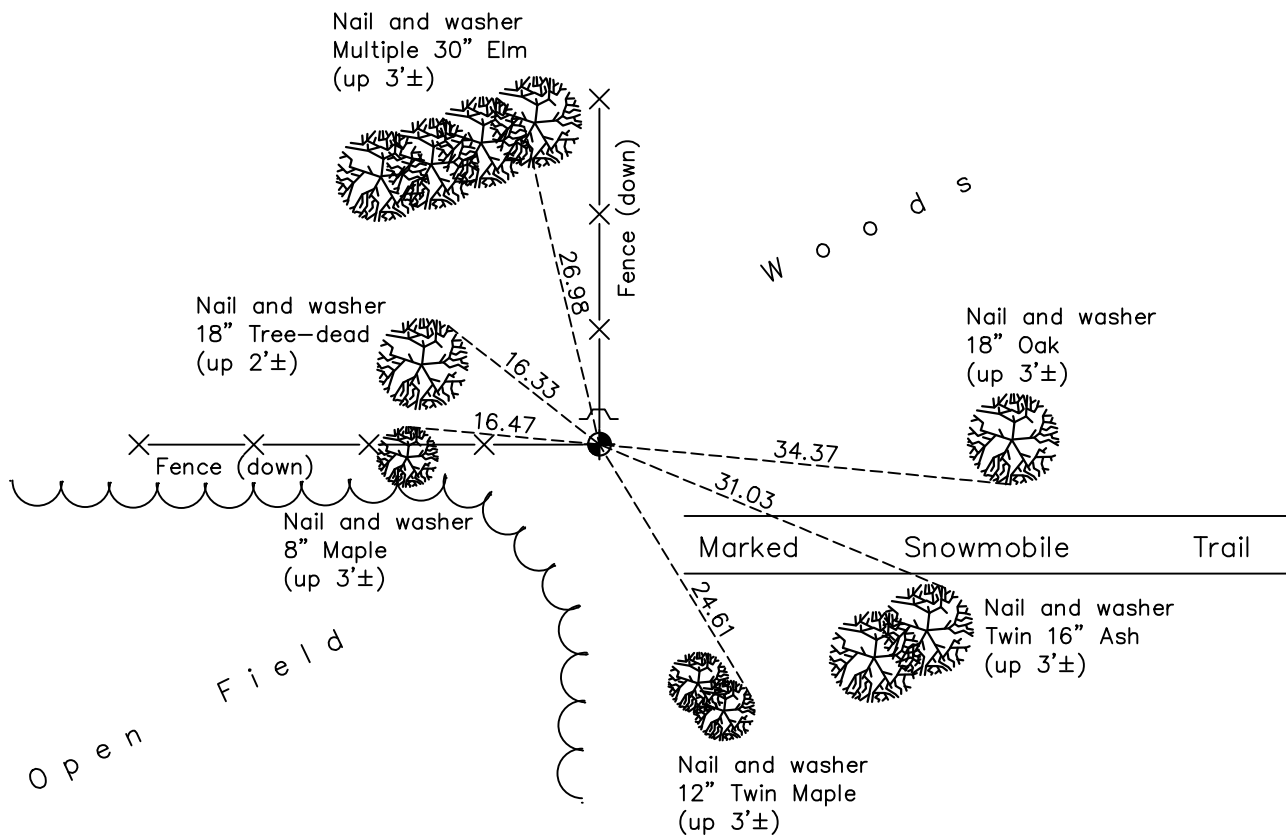

Revision Date

2/02/2023

N.A.D. 1983 Coordinates  
(1996 Adjustment)

County Project Coordinates	
Northing	<u>230163.3330</u>
Easting	<u>458157.3488</u>
Date	<u>5/08/03</u>

I hereby certify that this United States public land survey monument record is correct and complete to the best of my knowledge and belief.

*David Zieglmeier* Date 3/1/23

David Zieglmeier Anoka County Surveyor  
Minnesota License Number 46179

# HISTORY OF GOVERNMENT CORNER

Page No. 82

County of Anoka

State of Minnesota

West 1/4 Corner of Sec. 35 Township 34 Range 25

## **CORNER HISTORY:**

October 13, 1970 - Set cast iron monument flush on south side of corner fence post using area resurvey. Established ties to monument.

June 14, 1974 - Found cast iron monument and updated ties.

May 11, 1977 - Found cast iron monument and updated ties.

May 27, 1981 - Found cast iron monument and updated ties.

August 1, 1984 - Found cast iron monument and updated ties.

June 22, 1987 - Found cast iron monument and updated ties.

July 29, 1992 - Found cast iron monument w/sign and post on the north side. Updated ties.

May 8, 2003 - Found cast iron monument and updated ties. Established NAD 1983 (1996 adj.) Anoka County project coordinates by static GPS methods.

April 17, 2014 - Found cast iron monument w/ a "T" post on the north side. Updated ties.

September 23, 2020 - Found cast iron monument and updated ties.

November 16, 2022 - Found cast iron monument flush, verified position by VRS GPS method and updated ties.